


AS BUILT

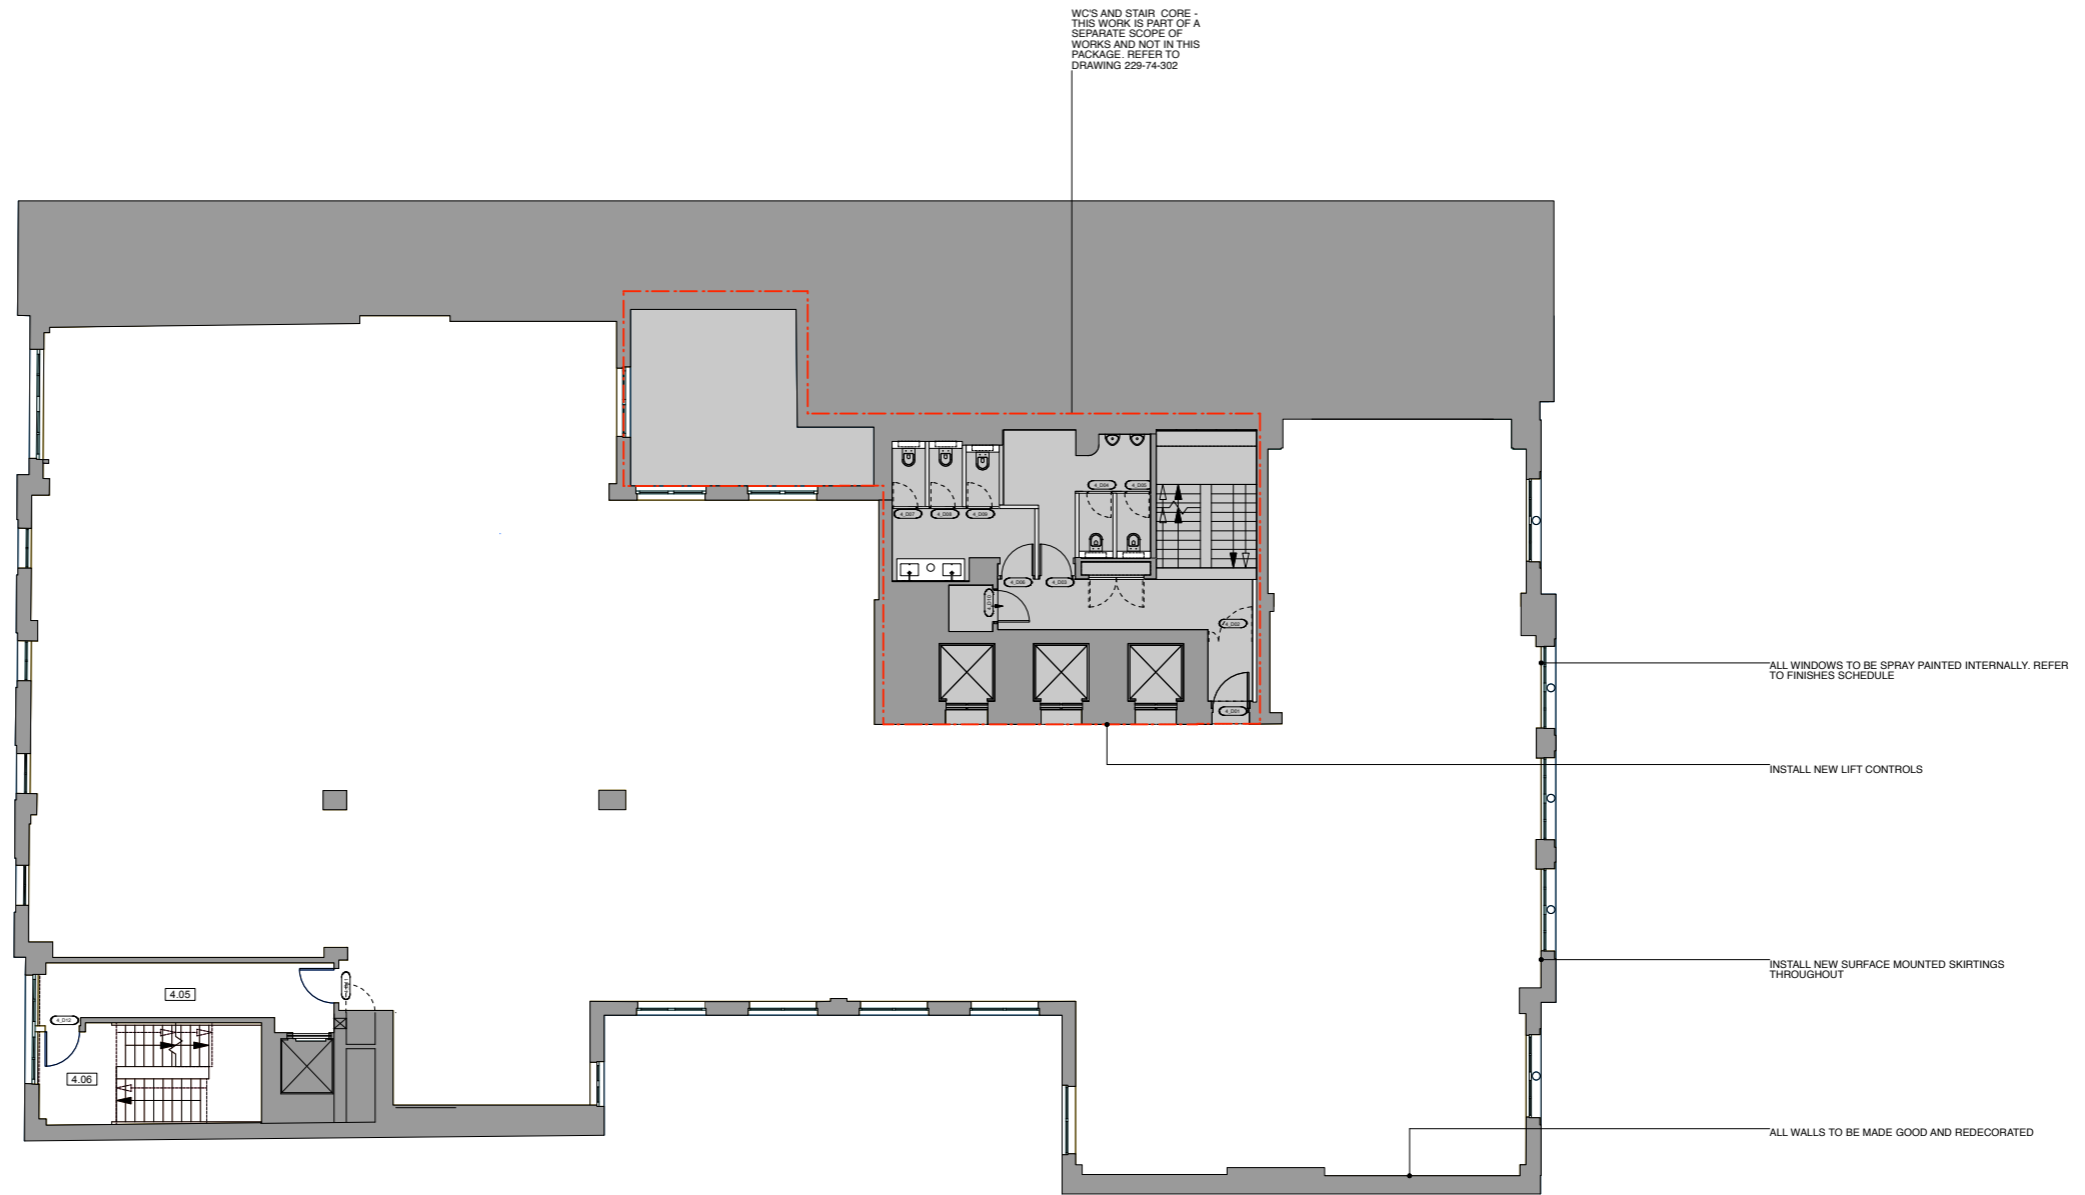

GENERAL NOTES
1. THIS DRAWING AND THE DETAILS CONTAINED THEREIN ARE COPYRIGHT AND ARE NOT TO BE REPRODUCED WITHOUT THE PERMISSION OF BLUEBOTTLE.
2. ALL DIMENSIONS RELATING TO ACTUAL SITE CONDITIONS ARE TO BE CHECKED ON SITE PRIOR TO ANY WORKS BEING COMMISSIONED OR EXECUTED.
3. USE FIGURED DIMENSIONS AND LEVELS ONLY. ALL DIMENSIONS ARE IN MM AND LEVELS ARE IN METER IF NOT OTHERWISE STATED.
4. THE AREAS ON THE DRAWING HAVE BEEN MEASURED FROM THE CAD DRAWING AND NO TOLERANCES ARE ADDED OR SUBTRACTED.
5. ACCURATE SITE SURVEY FOR SITE LEVELS, DIMENSIONS AND AREAS NEEDS TO BE FULLY EVALUATED.
6. CONTRACTORS ARE NOT TO SCALE FROM THIS DRAWING AND SHOULD REFER ANY QUERY IN RESPECT OF DIMENSIONS TO THE DESIGNERS.
7. THIS DRAWING IS TO BE READ IN CONJUNCTION WITH ALL MECHANICAL, ELECTRICAL AND STRUCTURAL ENGINEERS LAYOUT, AS WELL AS EMPLOYER'S AGENTS INFORMATION AND ASSOCIATED BLUEBOTTLE DRAWINGS AND DOCUMENTS.
8. ALL SERVICES LAYOUT SHOWN ON THIS DRAWING IS FOR COORDINATION PURPOSES ONLY. REFER TO SERVICES ENGINEERS DRAWINGS FOR DETAILED LAYOUT AND SPECIFICATIONS.

INFORMATION
1. DRAWINGS TO BE READ IN CONJUNCTION WITH FINISHES SCHEDULE, SANITARY WARE SCHEDULE, IRONMONGERY SCHEDULE AND LIGHTING SCHEDULE
2. LIGHT LEVELS AND HEAT OUTPUT TO BE PROVIDED AND CHECKED BY THE CONTRACTOR
3. MBE CONSTRUCTION DRAWINGS TO BE PRODUCED BY THE CONTRACTOR AND APPROVED BY DESIGNER

REVISIONS	REVISION NOTES	REVISION DATE	REVISION BY	CLIENT
C	CONSTRUCTION ISSUE	12-02-18	AS	BMO REAL ESTATE
B	AS BUILT	18-08-18	NA	CASSINI HOUSE CAT A

JOB NO.	DATE
239	25-09-17
SCALE	DRAWN BY
1:100@A1	AS
DRAWING NO.	REVISION
03-001	B

Architecture
+ Design

BLUEBOTTLE

13-14 Dean Street
London W1D 3RS
+44(0)20 7437 1017
mail@bluebottle.co.uk
bluebottle.co.uk