


AS BUILT

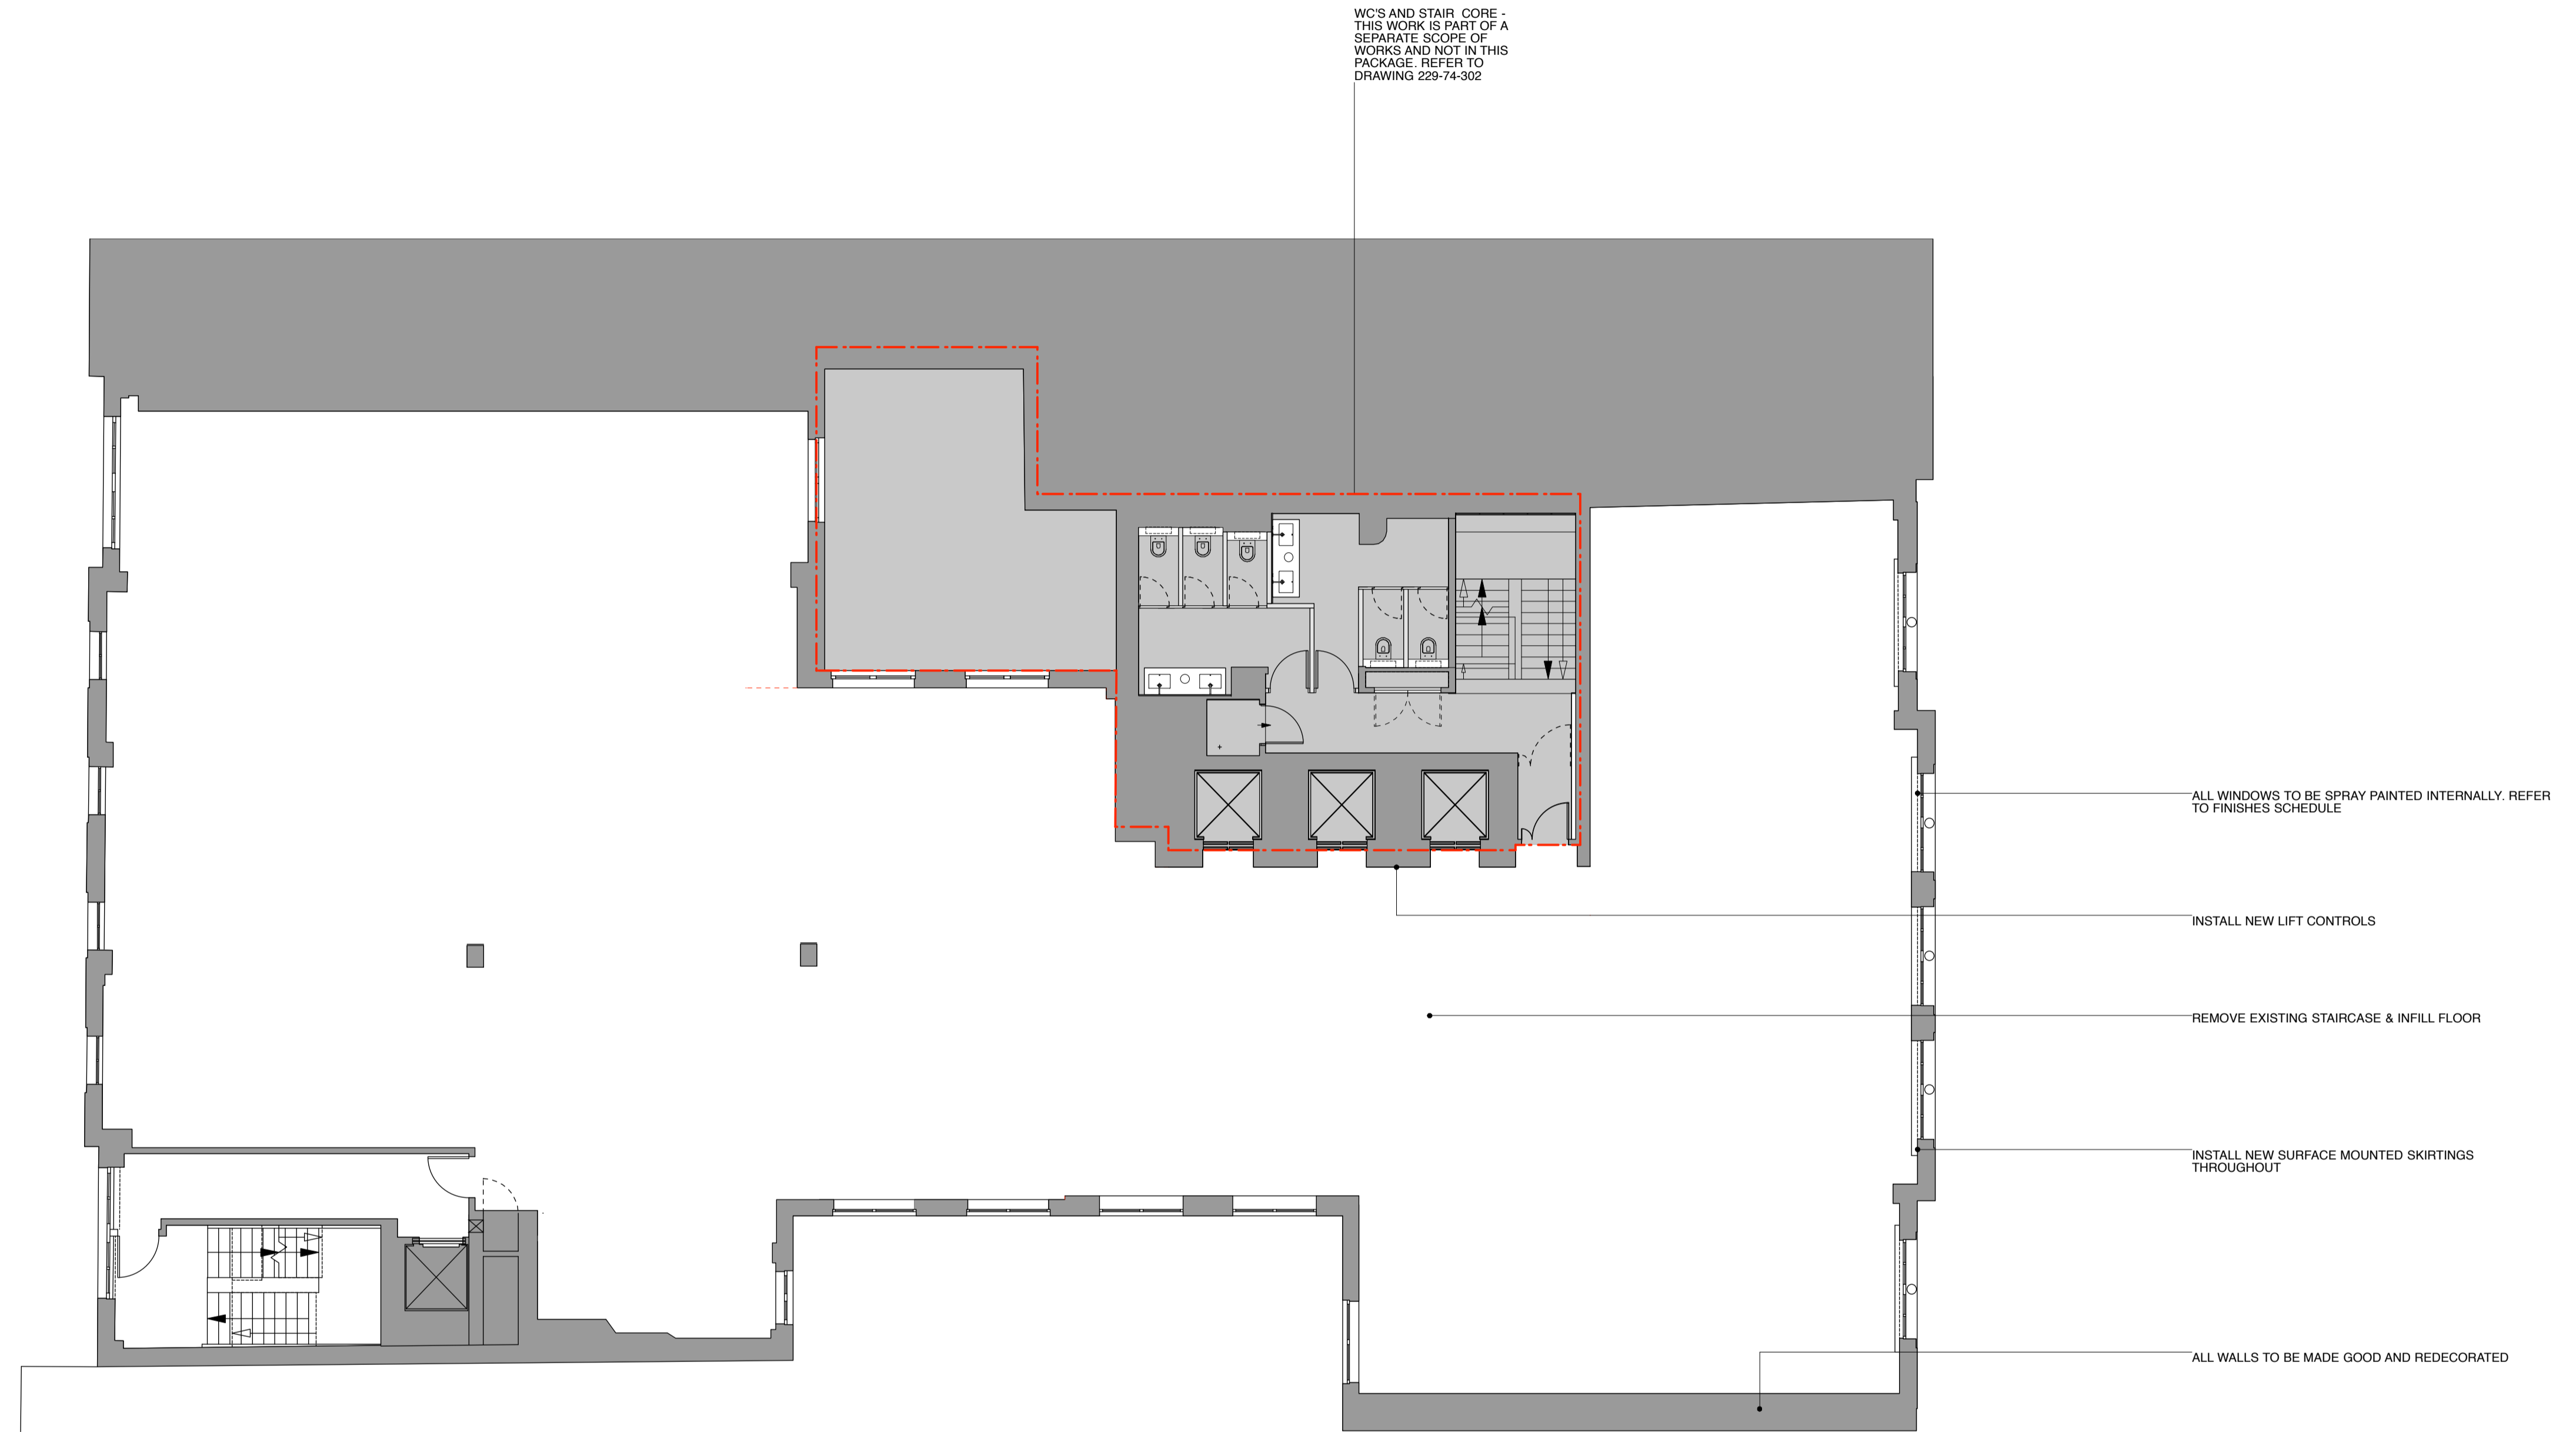

GENERAL NOTES
1. THIS DRAWING AND THE DETAILS CONTAINED THEREIN ARE COPYRIGHT AND ARE NOT TO BE REPRODUCED WITHOUT THE PERMISSION OF BLUEBOTTLE.
2. ALL DIMENSIONS RELATING TO ACTUAL SITE CONDITIONS ARE TO BE CHECKED ON SITE PRIOR TO ANY WORKS BEING COMMISSIONED OR EXECUTED.
3. USE FIGURED DIMENSIONS AND LEVELS ONLY. ALL DIMENSIONS ARE IN MM AND LEVELS ARE IN METER IF NOT OTHERWISE STATED.
4. THE AREAS ON THE DRAWING HAVE BEEN MEASURED FROM THE CAD DRAWING AND NO TOLERANCES ARE ADDED OR SUBTRACTED.
5. ACCURATE SITE SURVEY FOR SITE LEVELS, DIMENSIONS AND AREAS NEEDS TO BE FULLY EVALUATED.
6. CONTRACTORS ARE NOT TO SCALE FROM THIS DRAWING AND SHOULD REFER ANY QUERY IN RESPECT OF DIMENSIONS TO THE DESIGNERS.
7. THIS DRAWING IS TO BE READ IN CONJUNCTION WITH ALL MECHANICAL, ELECTRICAL AND STRUCTURAL ENGINEERS LAYOUT, AS WELL AS EMPLOYER'S AGENTS INFORMATION AND ASSOCIATED BLUEBOTTLE DRAWINGS AND DOCUMENTS.
8. ALL SERVICES LAYOUT SHOWN ON THIS DRAWING IS FOR COORDINATION PURPOSES ONLY. REFER TO SERVICES ENGINEERS DRAWINGS FOR DETAILED LAYOUT AND SPECIFICATIONS.

INFORMATION
1. DRAWINGS TO BE READ IN CONJUNCTION WITH FINISHES SCHEDULE, SANITARY WARE SCHEDULE, IRONMONGERY SCHEDULE AND LIGHTING SCHEDULE
2. LIGHT LEVELS AND HEAT OUTPUT TO BE PROVIDED AND CHECKED BY THE CONTRACTOR
3. M&E CONSTRUCTION DRAWINGS TO BE PROVIDED BY THE CONTRACTOR AND APPROVED BY DESIGNER

REVISIONS	REVISION NOTES	REVISION DATE	REVISED BY
C	CONSTRUCTION ISSUE	12-02-18	AS
C1	CURBING REMOVED FURTHER TO JHA COMMENTS	21-02-18	AS
C2	EXISTING STAIRCASE TO BE RETAINED	02-05-18	AS
C3	STAIRCASE REMOVED	04-07-18	NA
B	AS BUILT	12-09-18	NA

CLIENT	JOB NO.	DATE
BMO REAL ESTATE	239	25-09-17
PROJECT	SCALE	DRAWN BY
CASSINI HOUSE CAT A	1:100@A1	AS
DRAWING DESCRIPTION	DRAWING NO.	REVISION
PROPOSED FIFTH FLOOR GA	03-002	B

Architecture
+ Design

BLUEBOTTLE

13-14 Dean Street
London W1D 3PS
+44(0)20 7437 9117
mail@bluebottle.co.uk
bluebottle.co.uk